ITEM	DRAWING No	DESCRIPTION	QTY.	MASS (kg)
1	OEM-80NB-JIS5K-SO-316L	80NB PLATE FLANGE JIS 5K RAISED FACE SLIP ON 316L S/S	1	2
2	11-2839-1-1	80NB SHED 10 PIPE 316 S/S	1	3.85

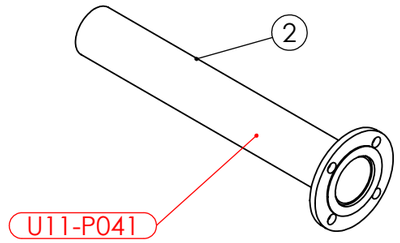

PIPE LABEL - U11-P041

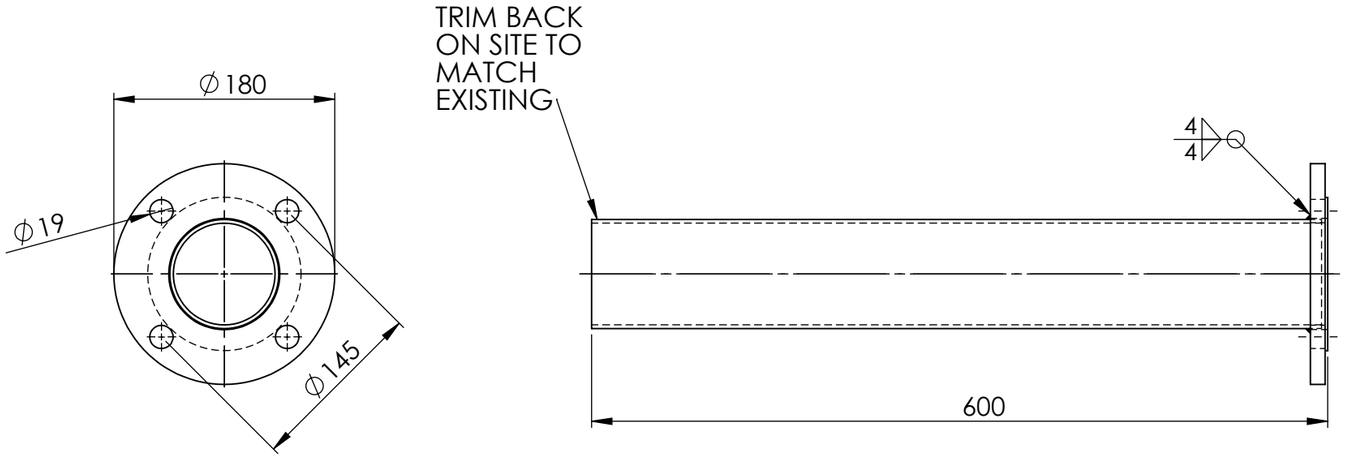

AS INSTALLED 14/3/25

PIPEWORK MANUFACTURED OF A JIG - FLANGES AS PER DRAWING
DIMENSIONS ARE APPROXIMATE

UNIT 11 VALVE 2839-1 DOWN STREAM PIPE WEIGHT - 5.66 kg

REV	NAME & DATE	DESCRIPTION

UNLESS OTHERWISE SPECIFIED:
TOLERANCES: MACHINE + / - 0.25mm
FABRICATION + / - 1.0 mm

THIS DRG SUPPLIED BY
RODDY ENGINEERING
14 Waratah St, TUMUT NSW 2720
Ph: 02 6947 4039

DRAWING No. 11-2839-1
REV:

DRAWN N DE BRUYN 27/03/2024
DRAWING CHECKED
DESIGNED
DESIGN CHECKED
SCALE 1:5
WORK ORDER No
APPROVED
SECTION No/KKS
A3 SHEET SIZE

snowyhydro LIMITED

M2 POWER STATION UNIT 11
VALVE 2839-1 DOWN STREAM PIPE

SMA-DRG-NO

REV

SHEET 1 OF 1

0,0