DIMENSIONS IN MILLIMETRES

ITEM	DRAWING No	DESCRIPTION	QTY.	MASS (kg)
1	OEM-100NB-PN25-SO-316L	100NB FLANGE PN25 SLIP ON 316L S/S	2	5.99
2	12-2919-3-2	100NB SHED 40 PIPE 316 S/S	1	53.01

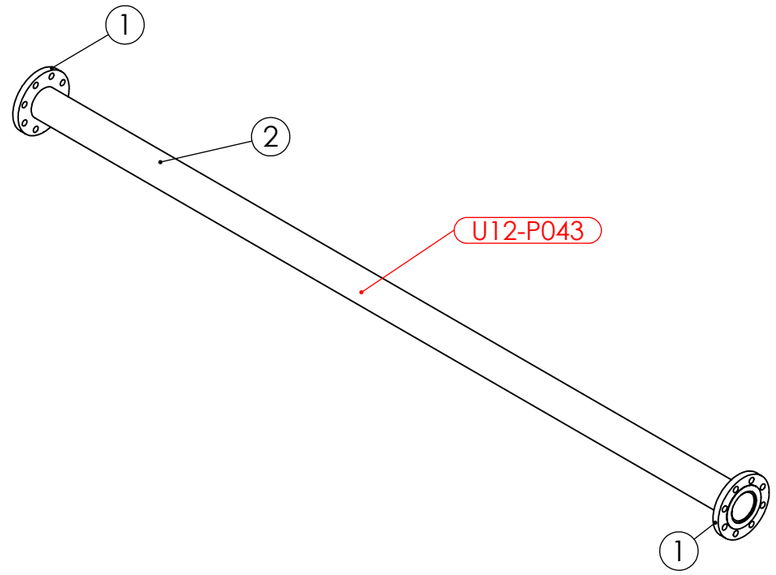

PIPE LABEL - U12-P043

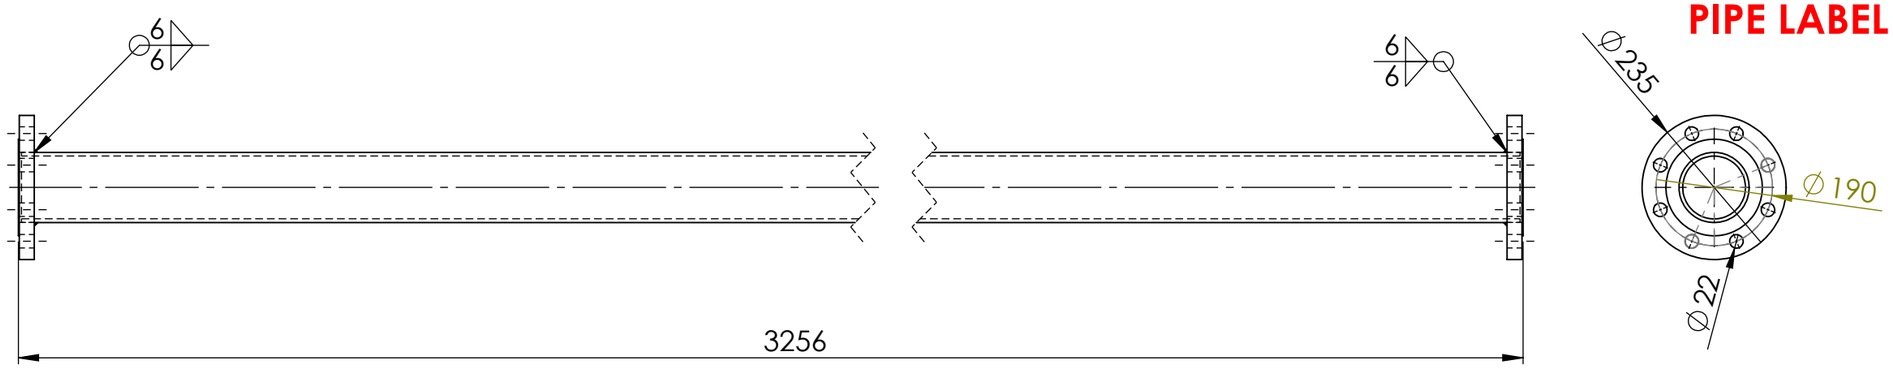

AS INSTALLED 14/3/25

PIPEWORK MANUFACTURED OF A JIG - FLANGES AS PER DRAWING
DIMENSIONS ARE APPROXIMATE

UNIT 12 VALVE 2919 DOWNSTREAM PIPE 3A WEIGHT - 64.99 kg

		UNLESS OTHERWISE SPECIFIED: TOLERANCES: MACHINE + / - 0.25mm FABRICATION + / - 1.0 mm	DRAWN N DE BRUYN 19/05/2024	DRAWING CHECKED	snowyhydro LIMITED
		THIS DRG SUPPLIED BY RODDY ENGINEERING 14 Waratah St, TUMUT NSW 2720 Ph: 02 6947 4039	DESIGNED	DESIGN CHECKED	M2 POWER STATION UNIT 12 VALVE 2919 DOWNSTREAM PIPE 3A
			SCALE 1:10 WORK ORDER No	APPROVED	
REV	NAME & DATE	DESCRIPTION	DRAWING No. 12-2919-3A REV:	SECTION No/KKS	A3 SHEET SIZE	SMA-DRG-NO	REV	SHEET 1 OF 1